



Purple line - potential changes




Black line – North Hertfordshire district boundary




Green line - Polling district boundary



Red line - District ward boundary

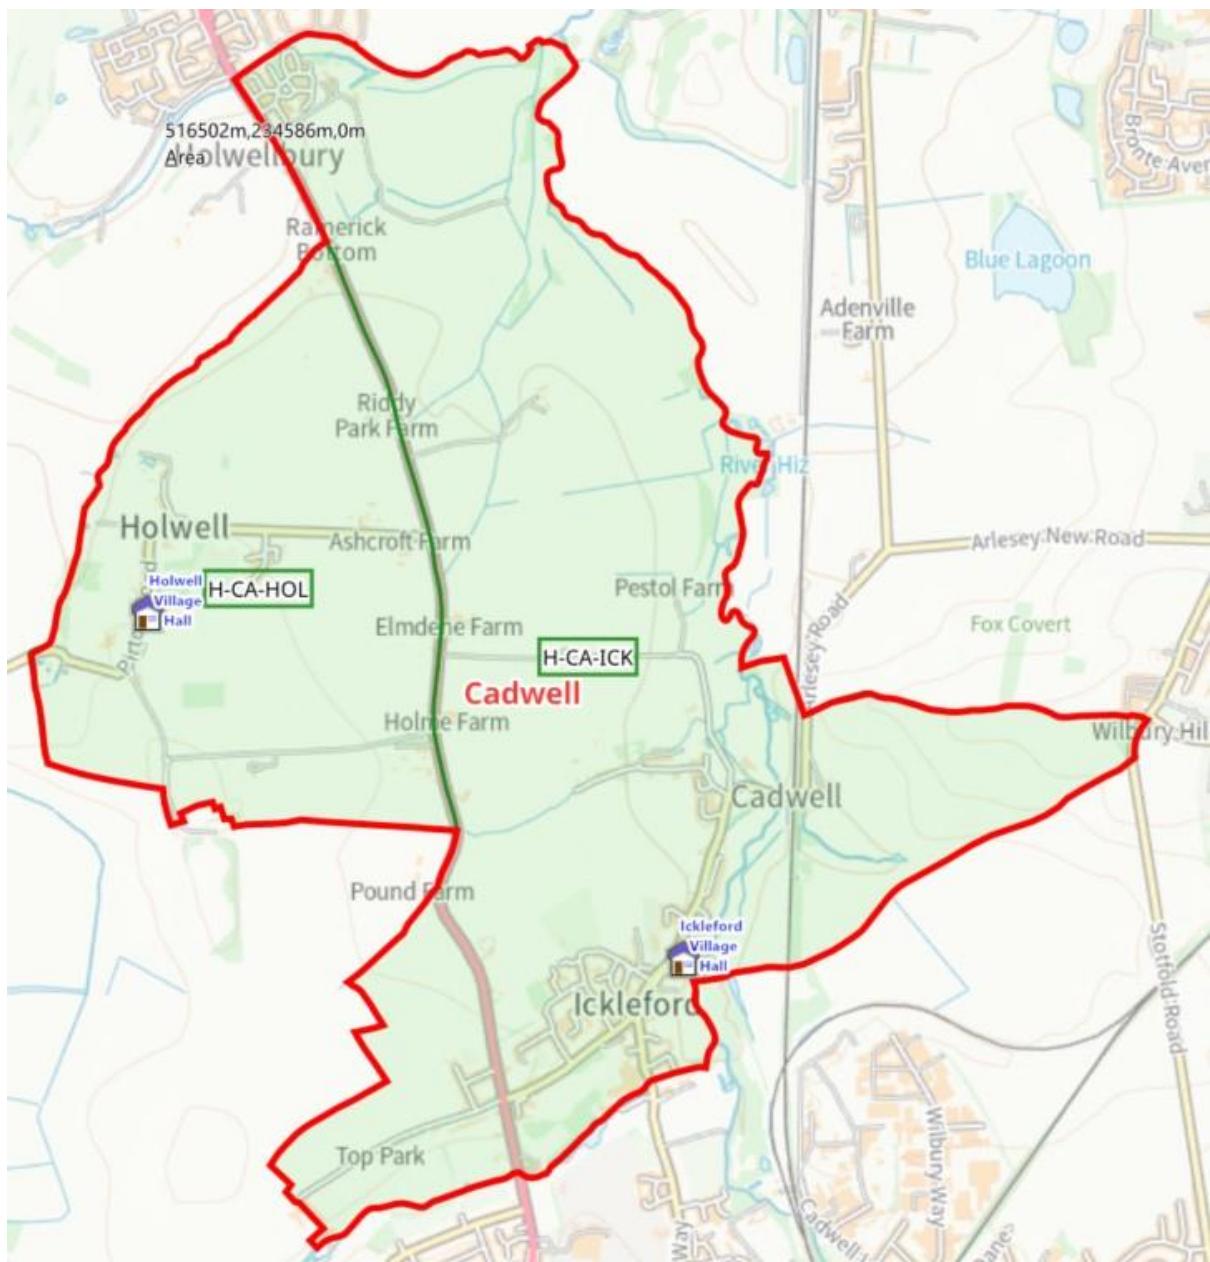Ickleford


Proposed boundary for creation of new polling district for Lavender Grange parish ward:

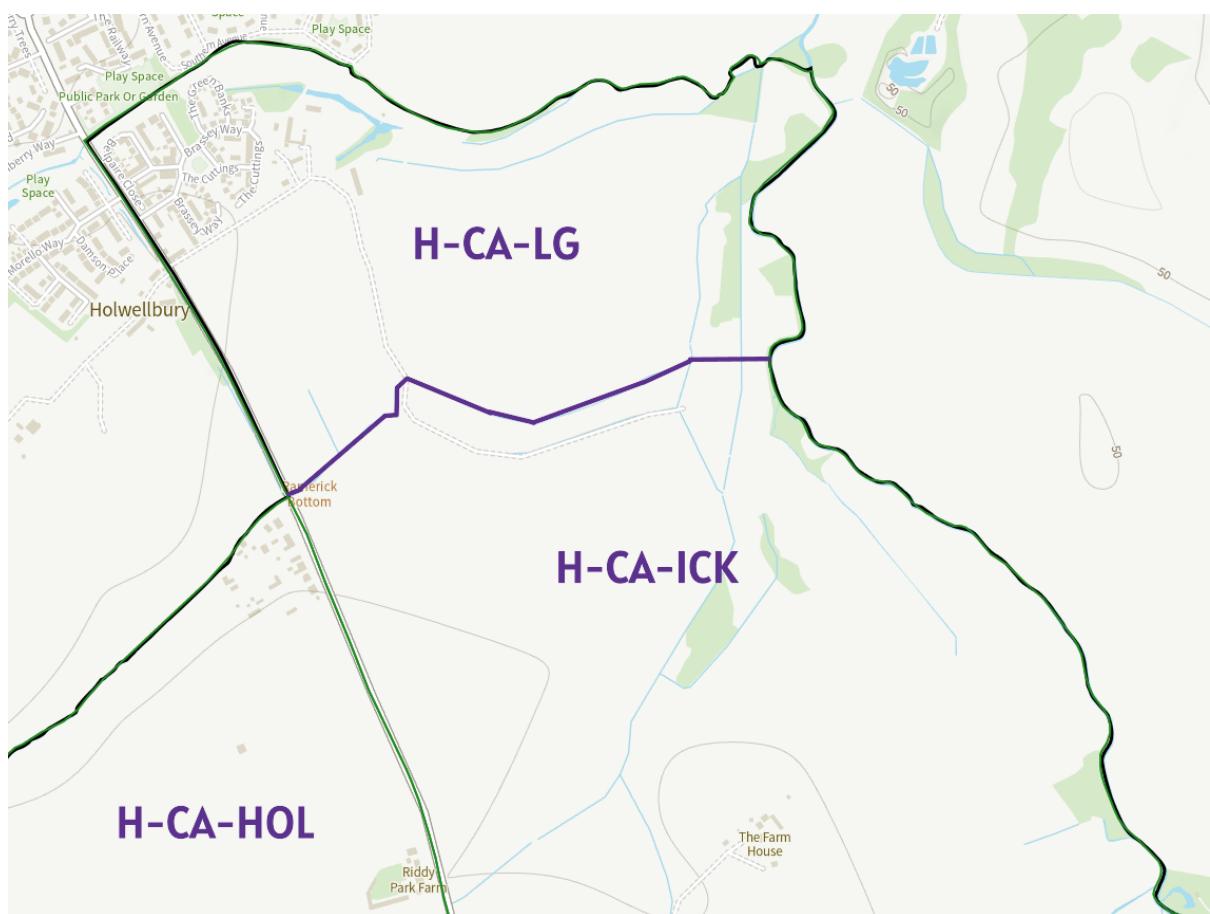


H-CA-HOL – Cadwell (Holwell)

H-CA-ICK – Cadwell (Ickleford)


H-CA-LG – Cadwell (Lavender Grange)

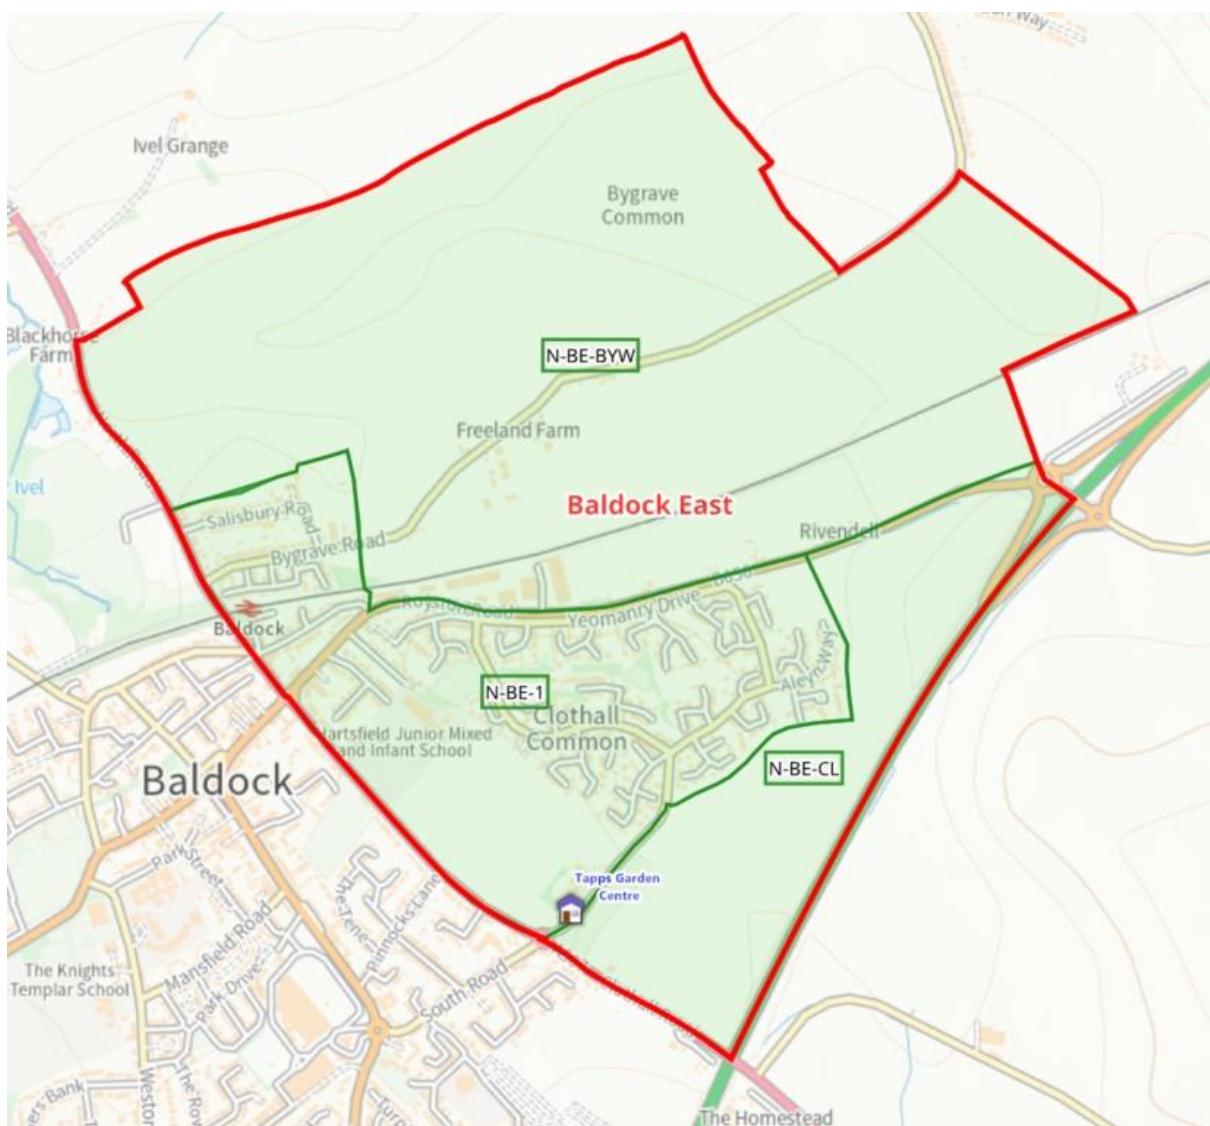Baldock East


Proposed merger of polling districts within Baldock East:

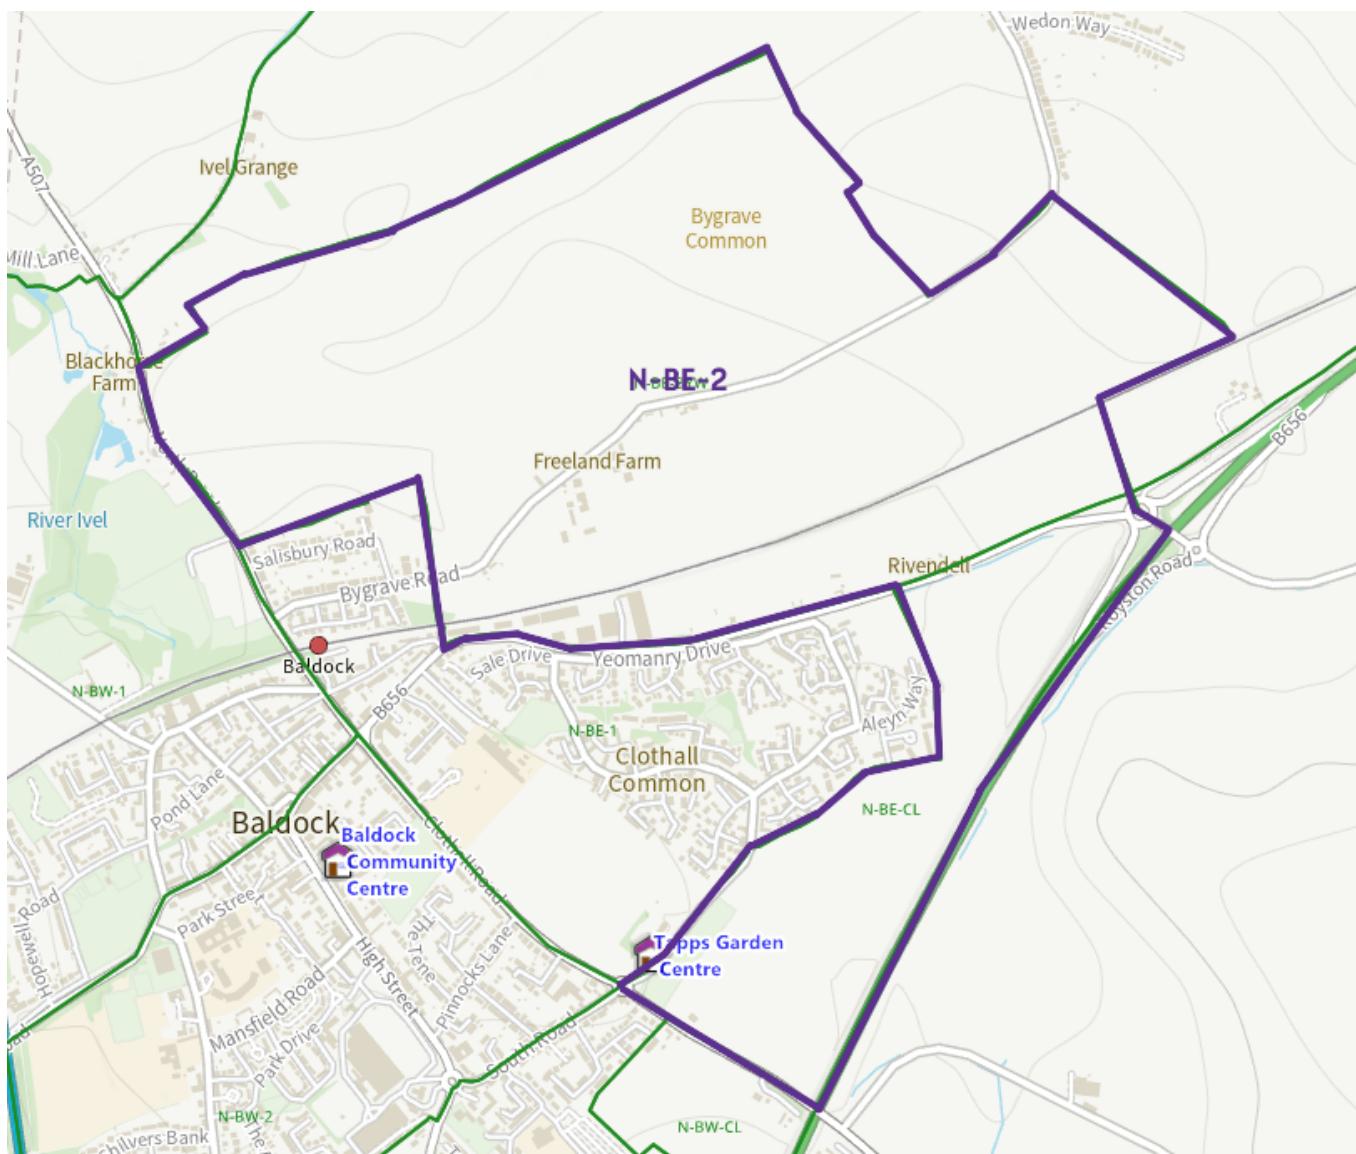

N-BE-2 – Baldock East 2

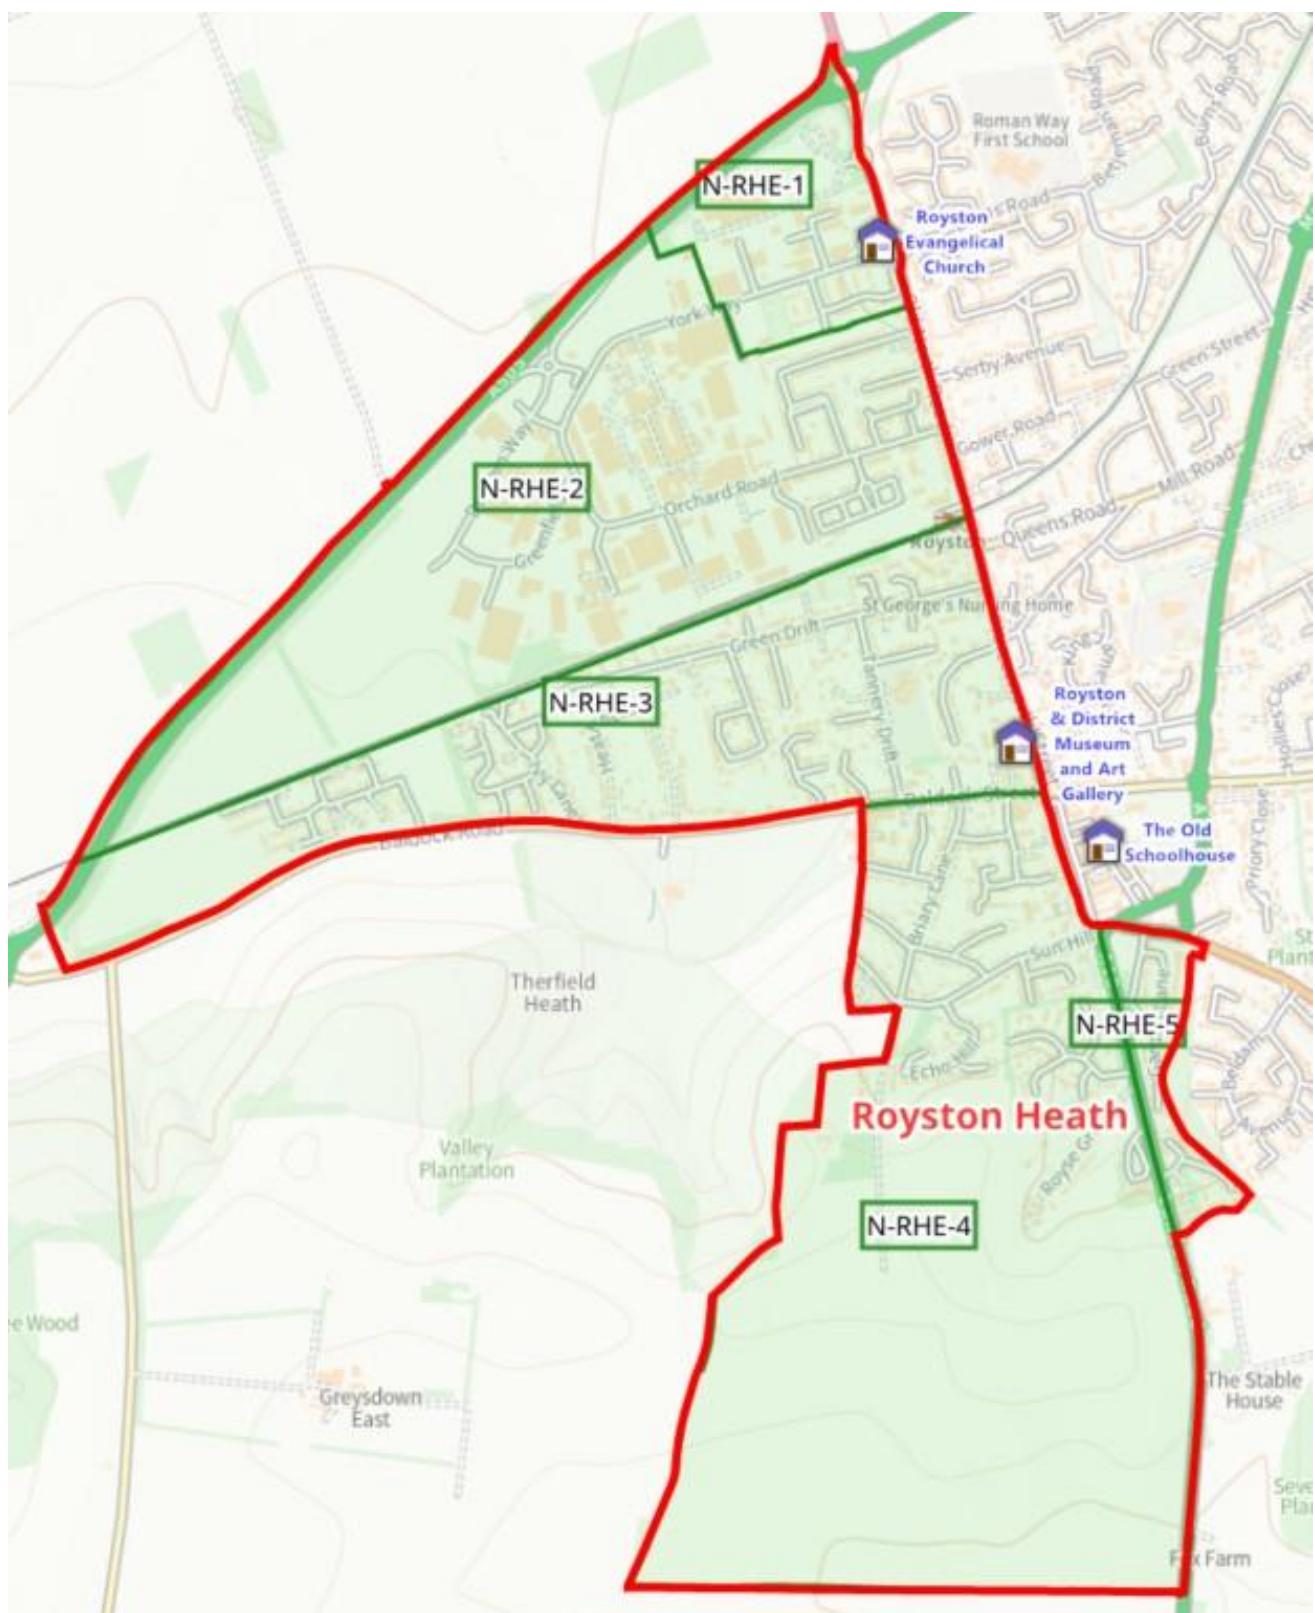
Royston

APPENDIX E

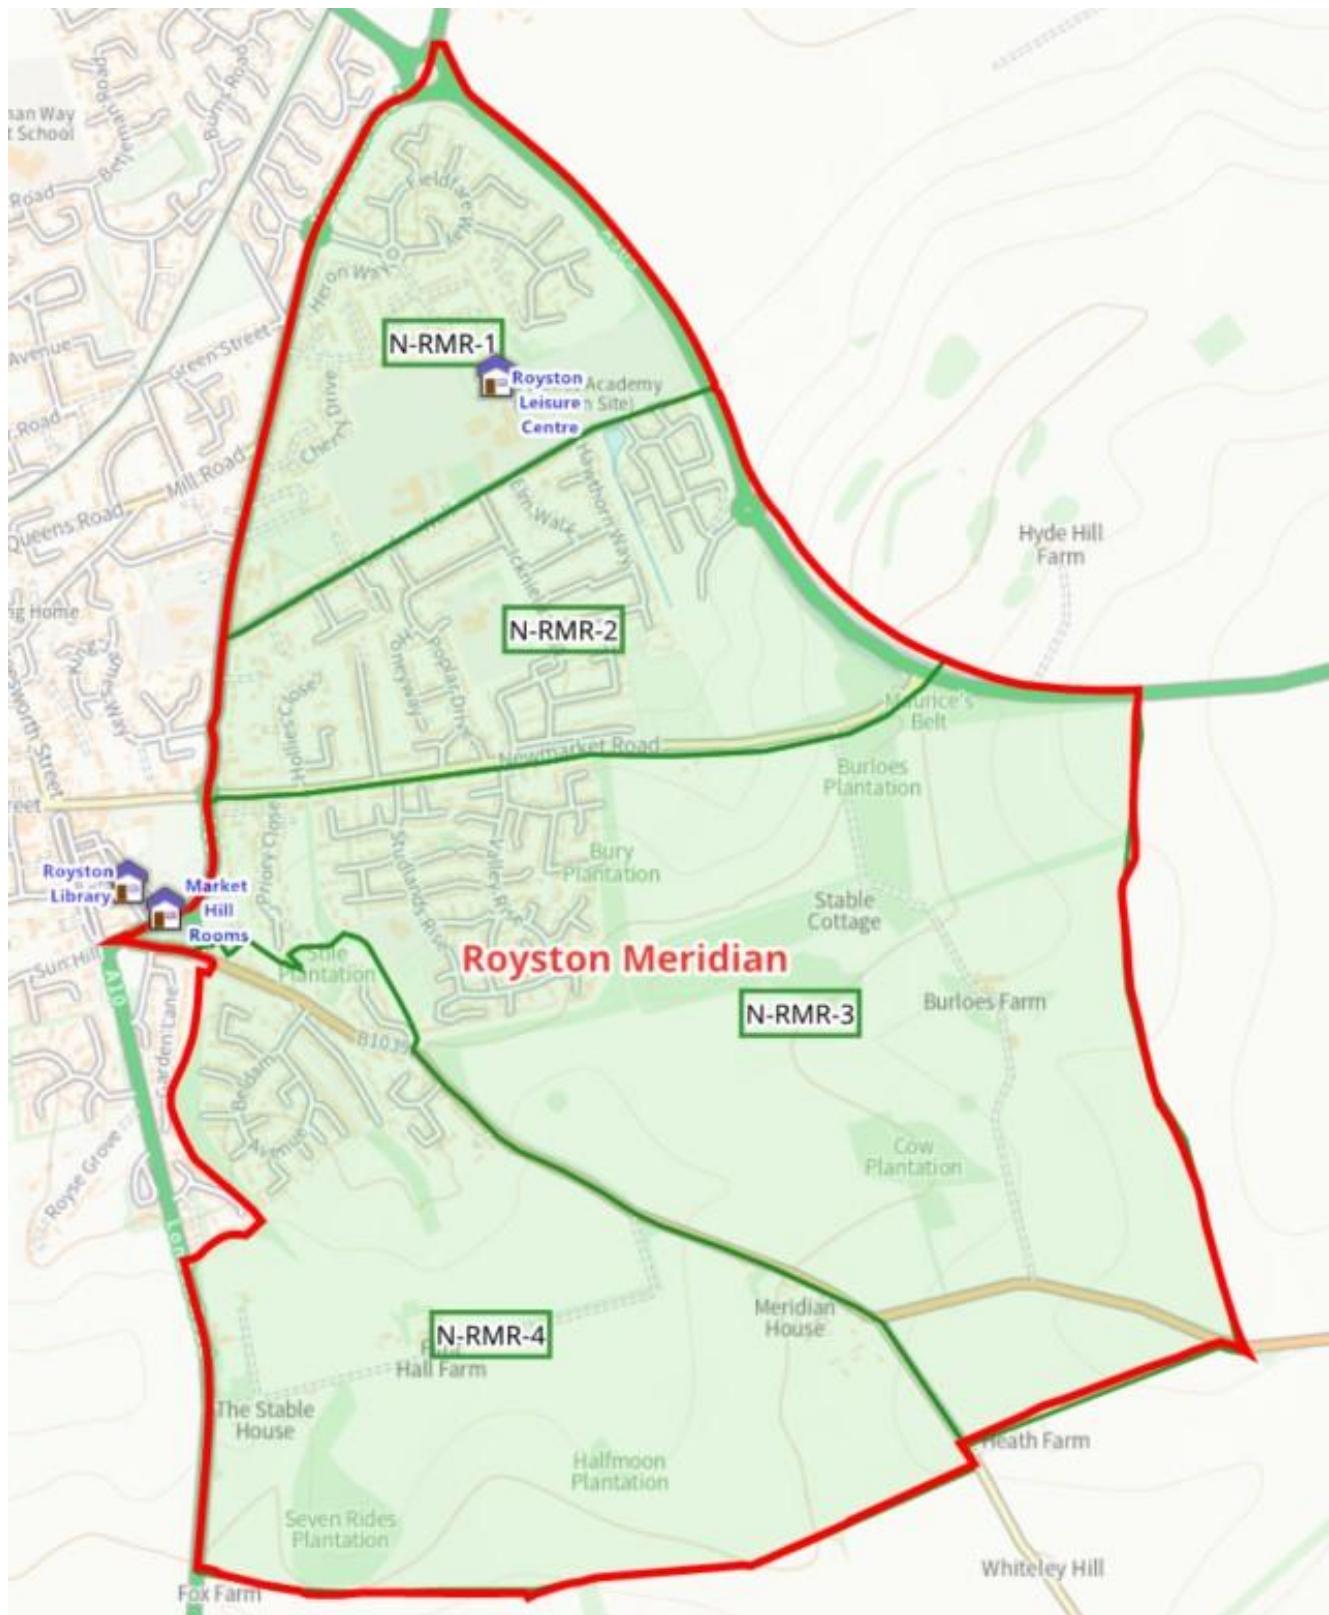



Proposed changes to the Royston polling districts:

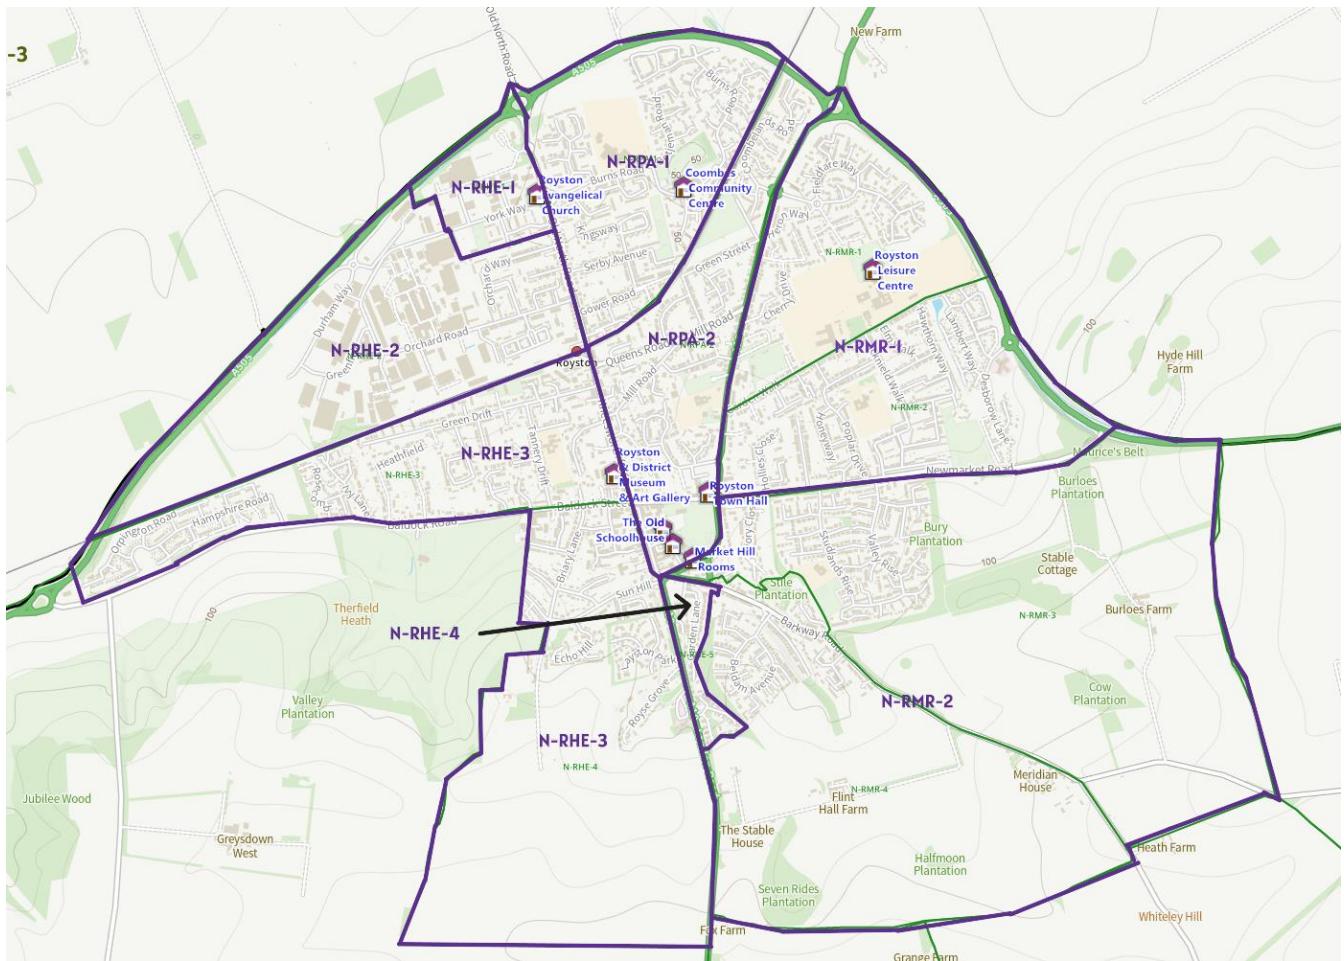

N-RHE-1 – Royston Heath 1

N-RHE-1 – Royston Heath 2

N-RHE-1 – Royston Heath 3

N-RHE-1 – Royston Heath 4

N-RPA-1 – Royston Palace 1

N-RPA-2 – Royston Palace 2

N-RMR-1 – Royston Meridian 1

N-RMR-2 – Royston Meridian 2

N-RHE-3 – Royston Heath 3

N-RHE-4 – Royston Heath 4

N-RPA-1 – Royston Palace 1


N-RPA-2 – Royston Palace 2

N-RMR-1 – Royston Meridian 1

N-RMR-2 – Royston Meridian 2

N-RMR-3 – Royston Meridian 3

Hitchin Walsworth (Billing Place)

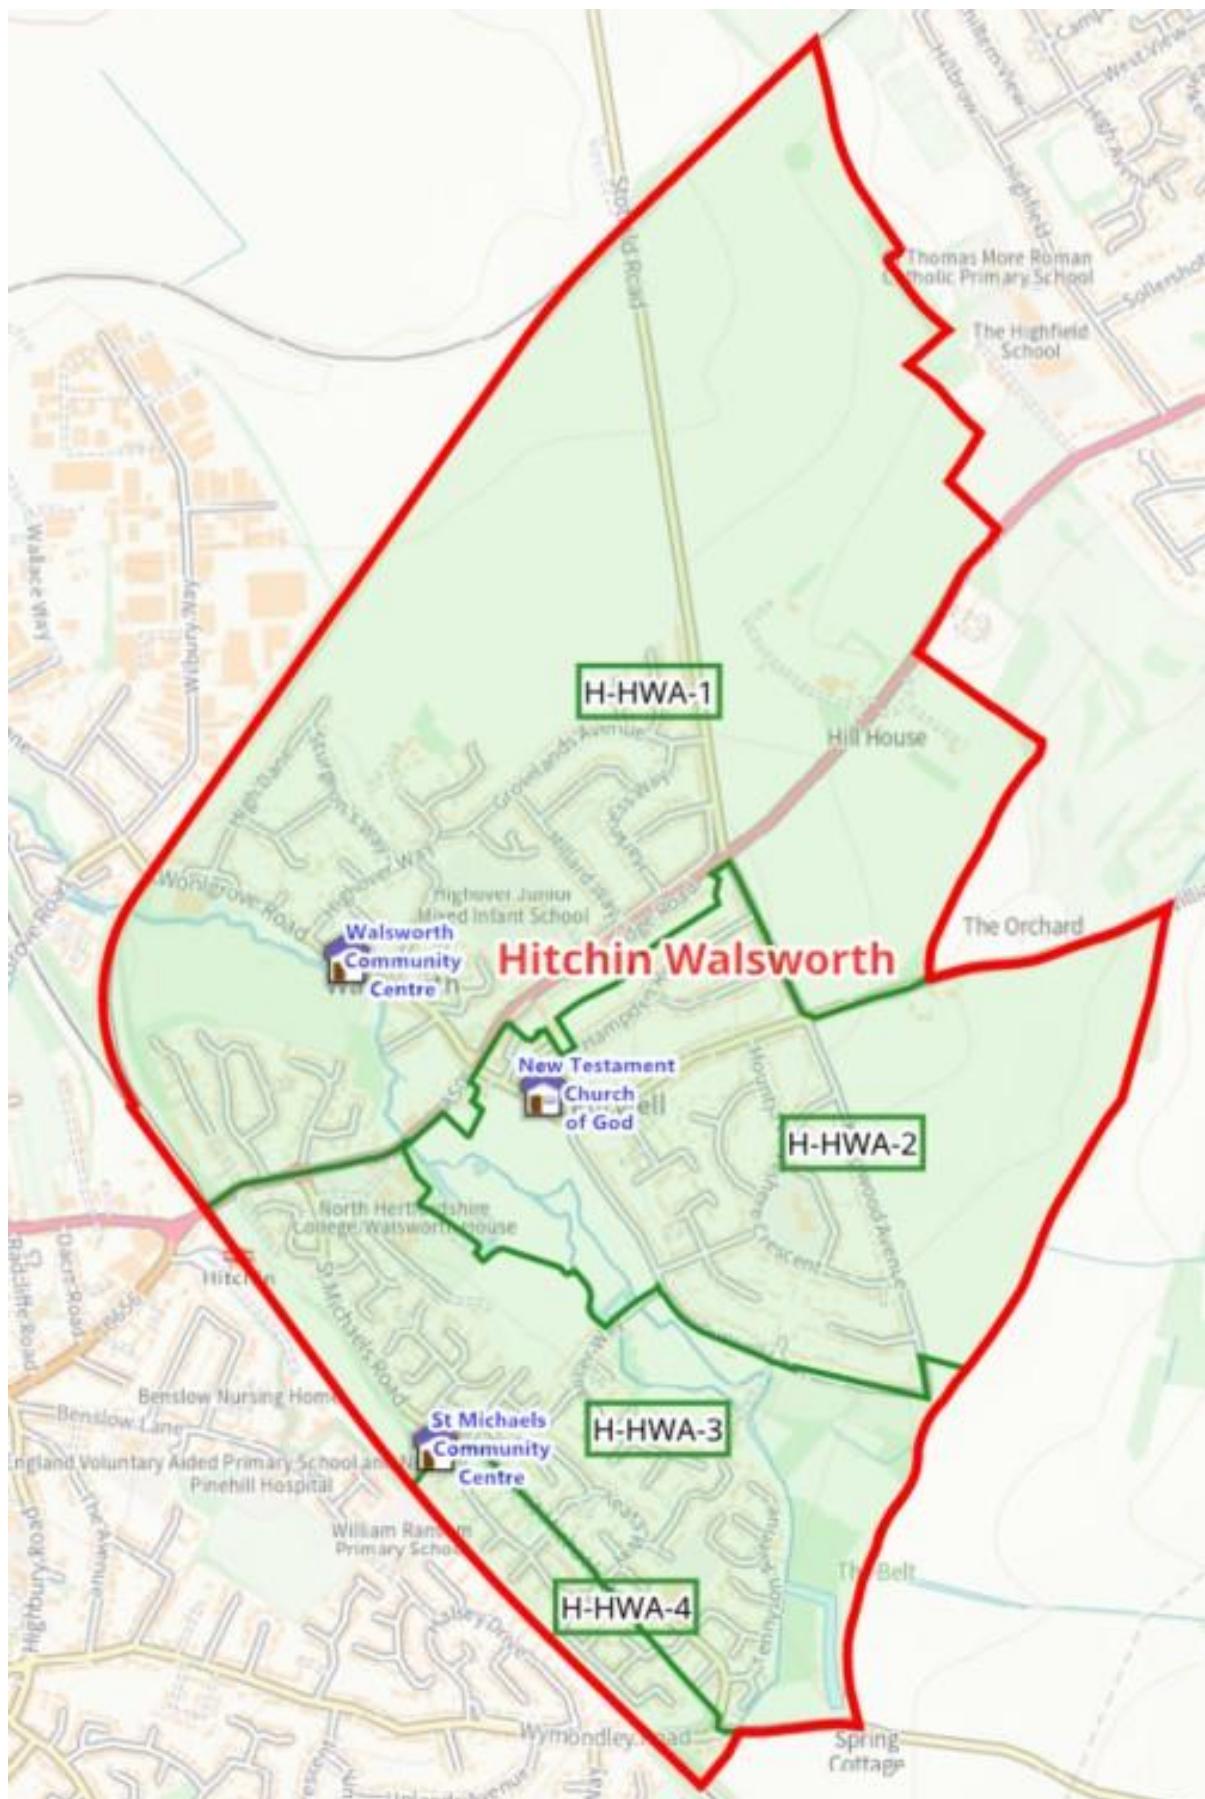

Proposed changes to the boundary around Billing Place:



H-HWA-1 – Hitchin Walsworth 1

H-HWA-2 – Hitchin Walsworth 2